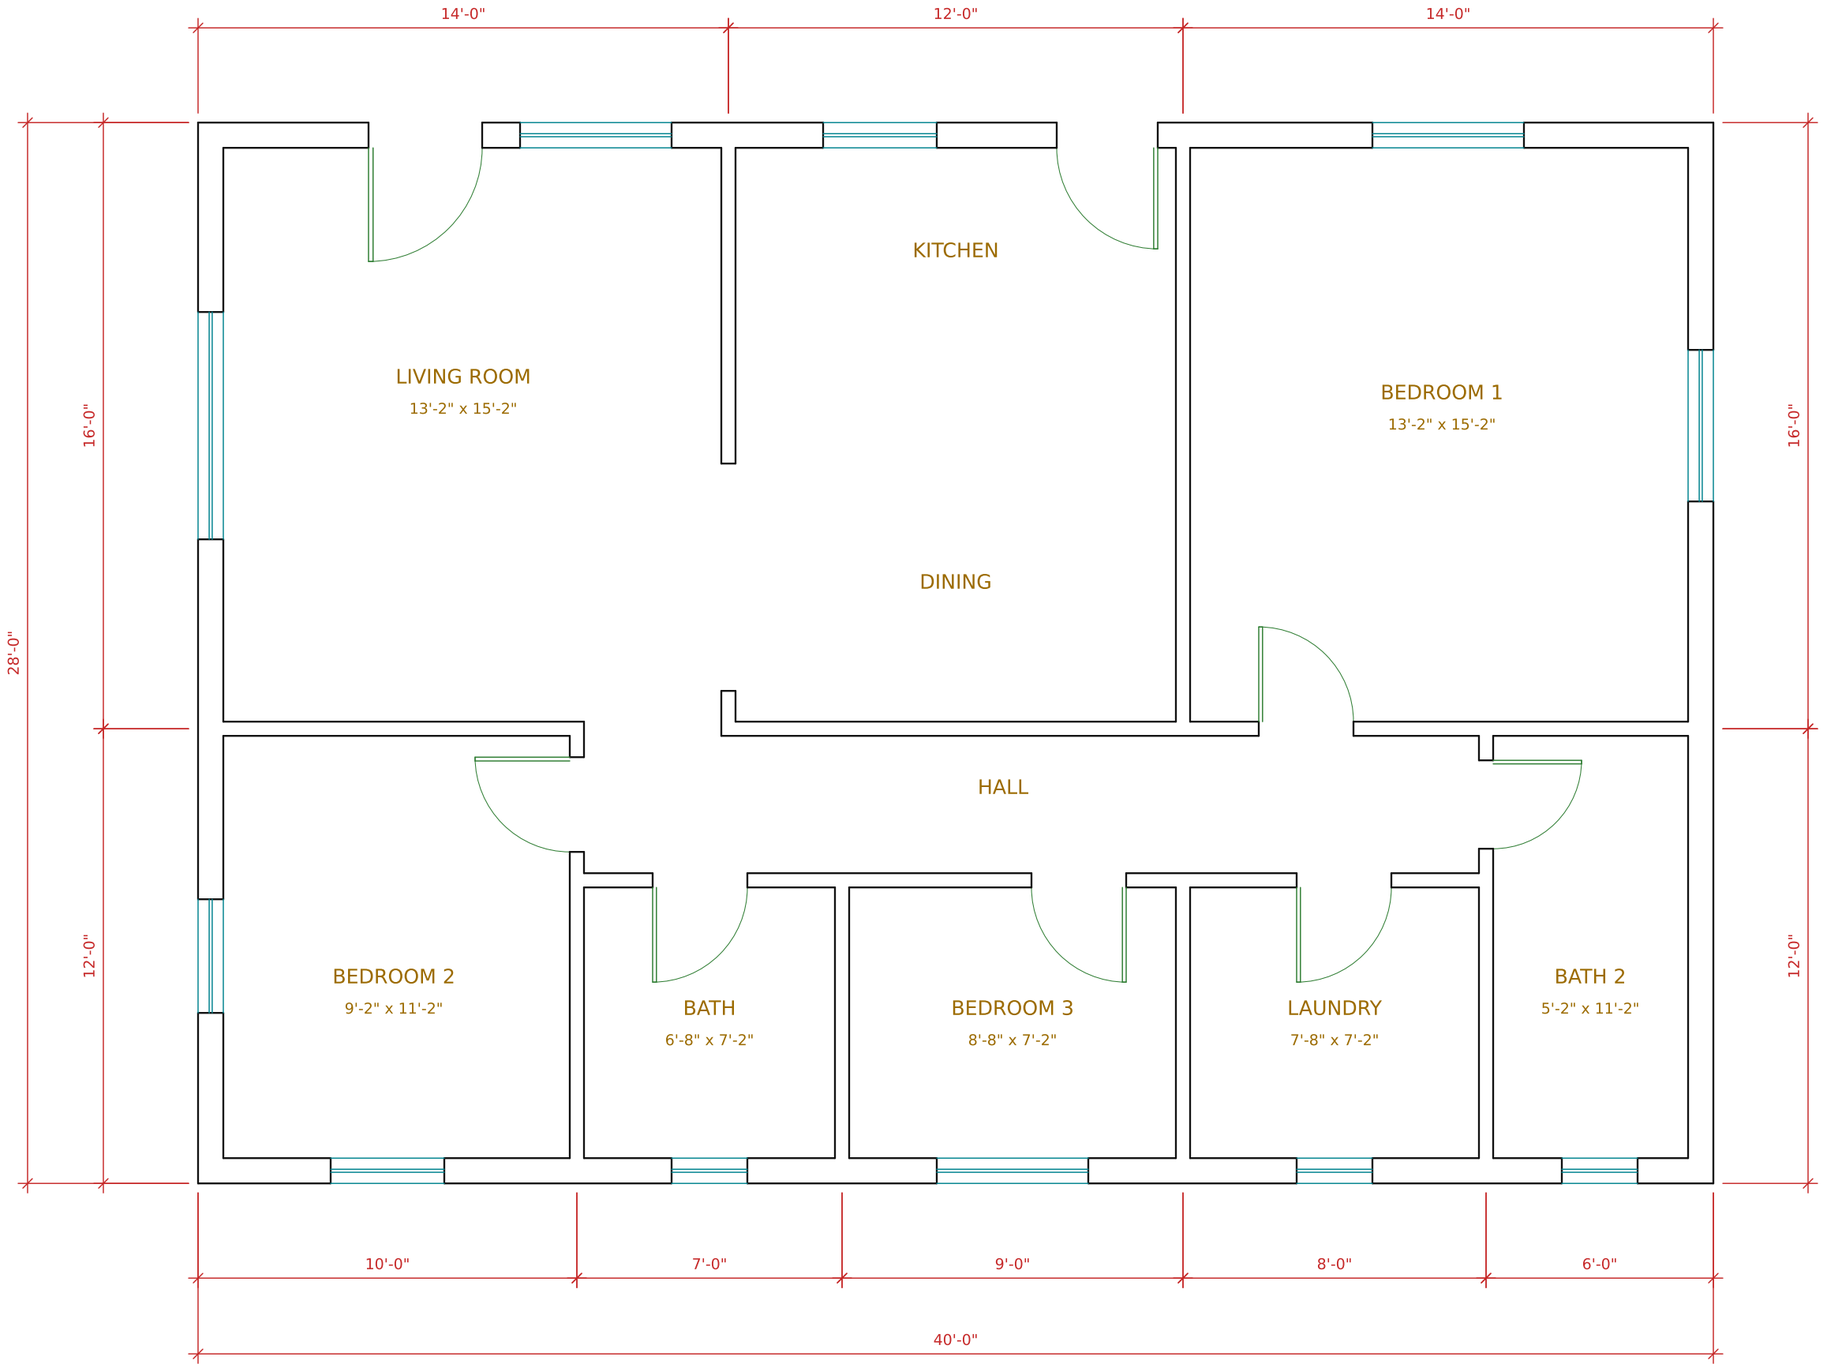

REDRAWN FROM SCANNED PLAN NO. 62-114 (1962). DIMENSIONS TAKEN FROM THE SCAN, SCALED TO THE 40'-0" OVERALL - VERIFY ON SITE.

INTERIOR DIMENSIONS TO PARTITION CENTERLINES, EXTERIOR TO OUTSIDE FACE OF WALL.

1 / A-101

AS-BUILT FLOOR PLAN

SCALE: 1/4" = 1'-0"

LAYERS IN THE DWG

A-WALL	walls, clean closed lines
A-DOOR	doors, block DOOR (scaled per width)
A-GLAZ	windows, block WINDOW
A-ANNO-TEXT	room names and sizes
A-ANNO-DIMS	true dimensions, architectural units
A-ANNO-NOTE	notes

REDRAW NOTES

1. Source: scanned blue-line print, plan 62-114 (1962).
2. Scan is skewed 0.8 deg and stretched about 1.2%:
   deskewed and scaled to the 40'-0" overall dimension,
   checked against the 28'-0" dimension.
3. Model space 1:1 in inches, architectural units.
4. Doors and windows are blocks, so they can be counted.
5. Room sizes clear between wall faces.
6. Portfolio sample.

PROJECT	**3 BEDROOM RESIDENCE - PLAN 62-114**
	PORTFOLIO SAMPLE
SHEET	**AS-BUILT FLOOR PLAN (REDRAWN)**
DRAWN	SERGEI GRISHUTOV, CAD DRAFTER
SCALE	1/4" = 1'-0" @ 11×17
DATE	NOV 2026

NOT FOR CONSTRUCTION

A-101